


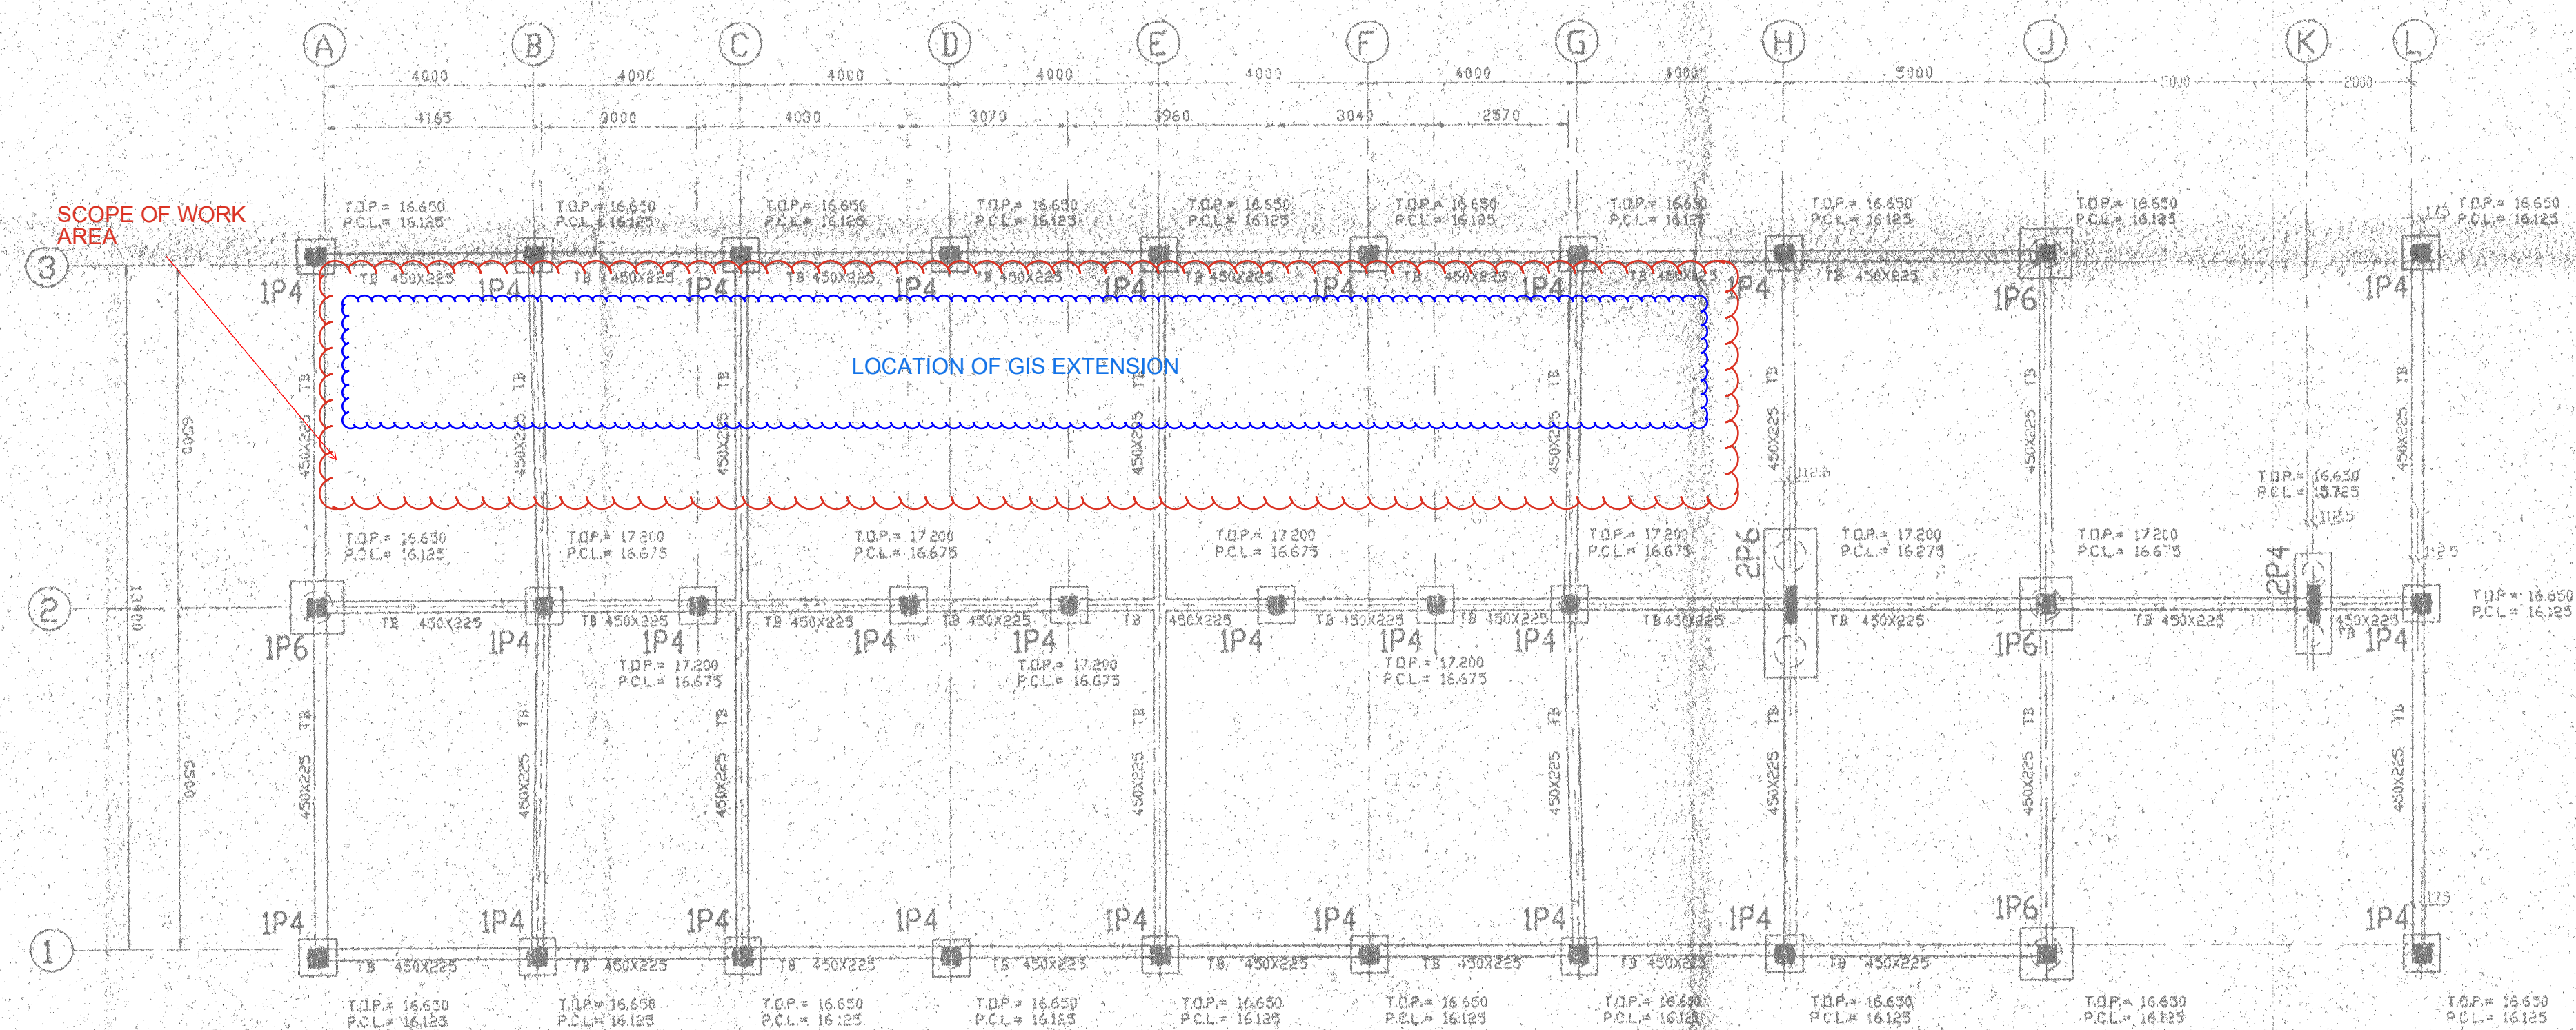

NOTE

1. TDP = TOP OF PILE CAP

2. PCL = PILE CUT OFF LEVEL

REVISION	MARK	DATE	BY

CLIENT

AMEDEO / UNITECH INTERNATIONAL

PROJECT

AMEDEO POWER SYSTEM DEVELOPMENT

PROPOSED MANGGIS 1 SUB-STATION AND TRANSFORMER YARDS

66KV SUB-STATION

OWB TITLE

FOUNDATION PLAN

SCALE	DRAWN	DATE
1 : 100	TIM	JUNE 1995
CHECKED	PASSED	TINOWS

OVE ARUP dan RAKAN-RAKAN BRUNEI

DRC NO. B338/MG1/66/P/1

FILENAME: G:\B338\MG1\66\66P

18 OCT 1995

AS-BUILT